



Survey Reading Positions

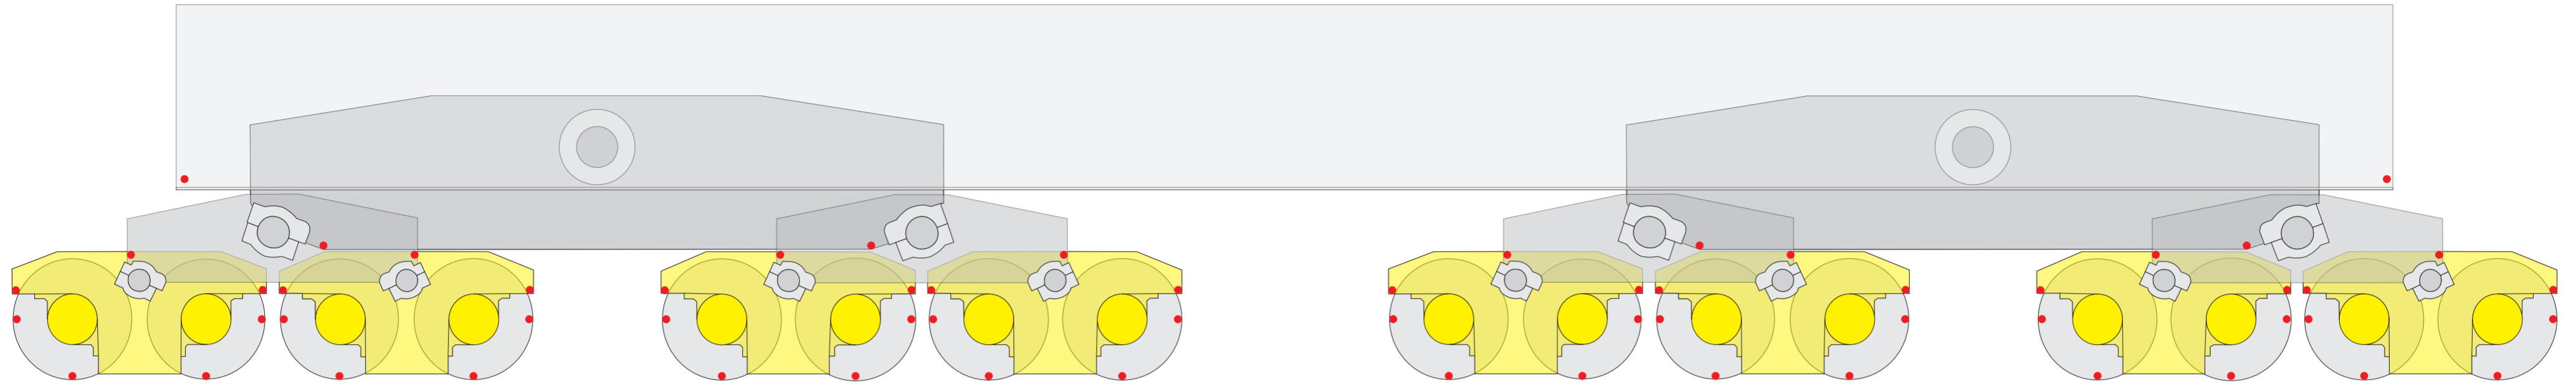


North End Carriage

Deviation from Datum - Plan View

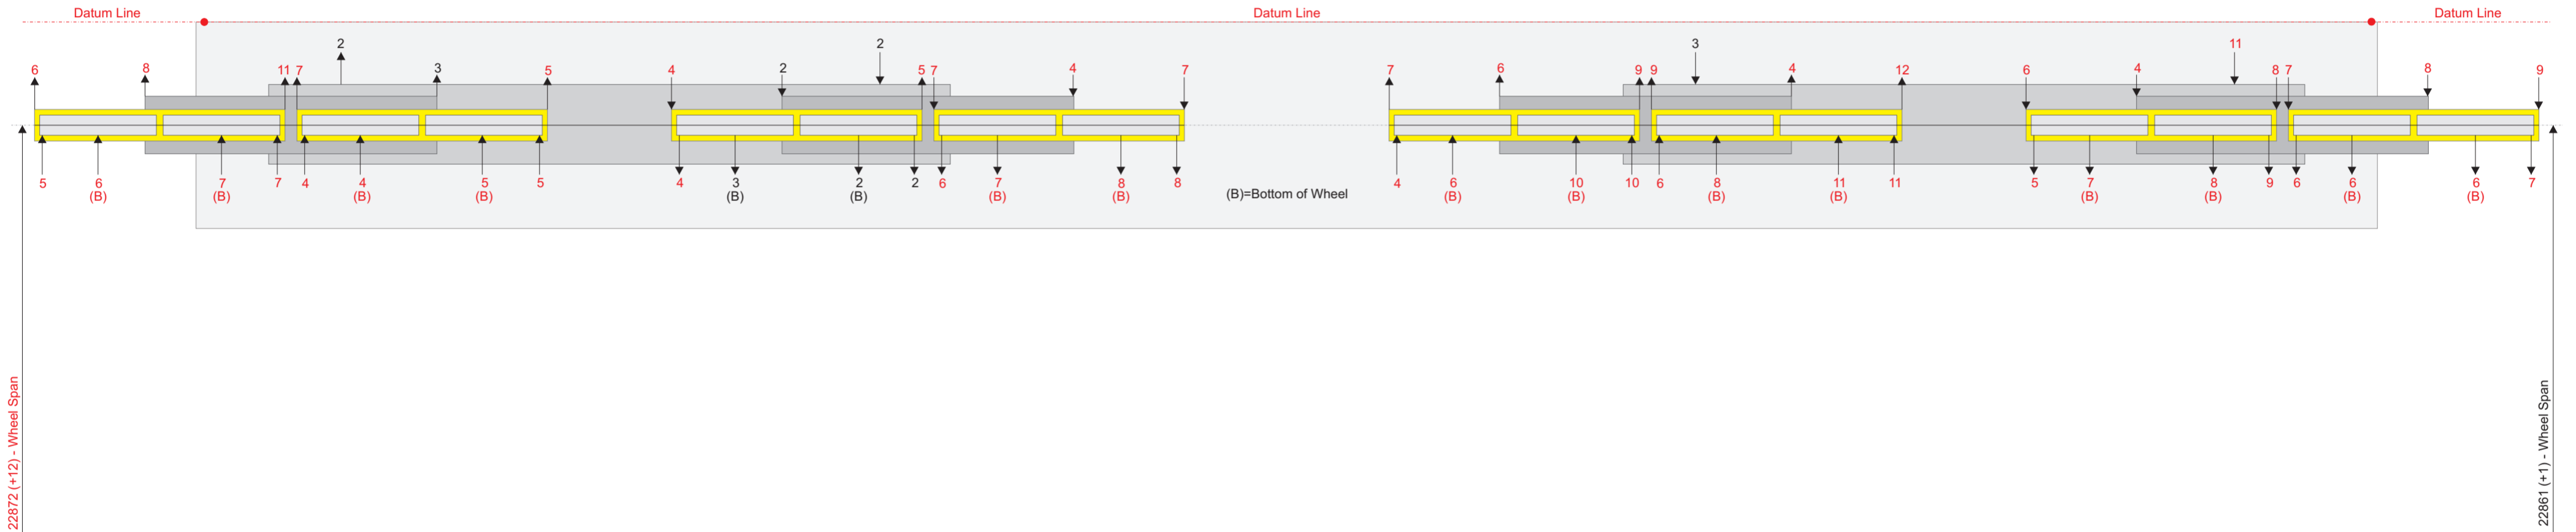


South End Carriage

Deviation from Datum - Plan View

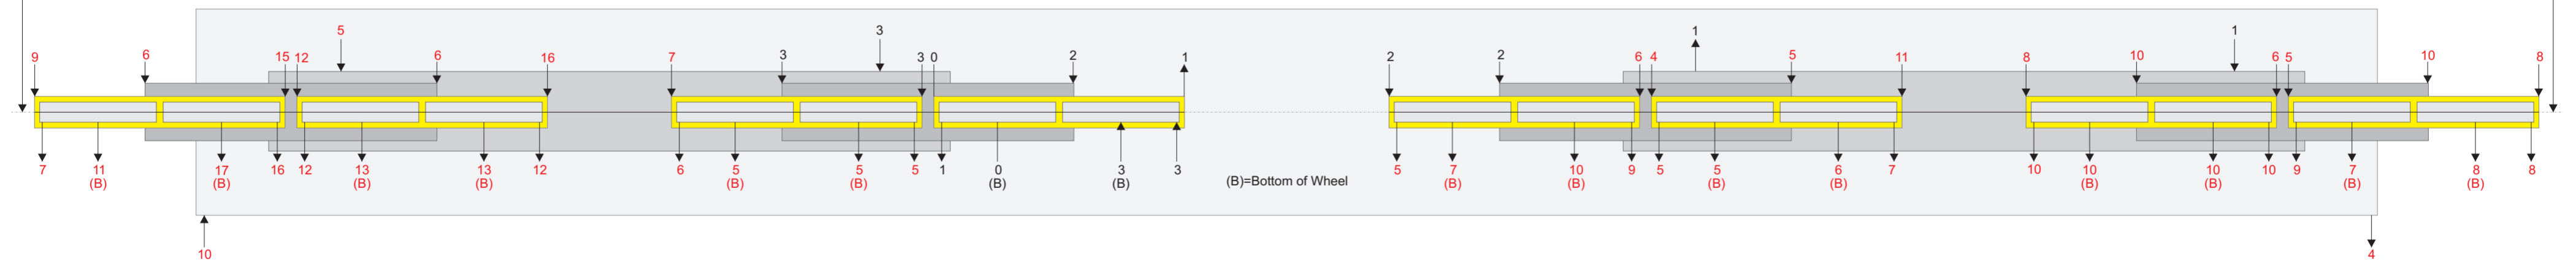

NOTES:
 • ALL DIMENSIONS ARE IN MM UNLESS OTHERWISE STATED
 • DEVIATIONS IN EXCESS OF 3MM SHOWN IN RED
 • DATUM REFERENCE LINE TAKEN ON NORTH END CARRIAGE AS INDICATED -
 ALL DEVIATIONS SHOWN ARE CALCULATED FROM THIS DATUM LINE USING
 DESIGN DIMENSIONS PROVIDED BY CLIENT



crane rail surveys

PO Box 466 • Ross-on-Wye • HR9 9AX t: 01989 770000 f: 01989 500700
<http://www.crsurveys.co.uk> sales@crsurveys.co.uk

ISSUE	DETAILS	DATE
A	INITIAL ISSUE	00/00/00

Client Example	
Site Example	
DWG No. DWG1000	Contract No. J1000
Title Alignment & Span Survey Readings for Crane Compensator & Wheel Assemblies	

DO NOT SCALE, IF IN DOUBT ASK

Sheet 1 of 1